

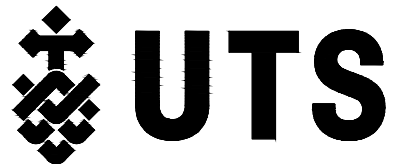
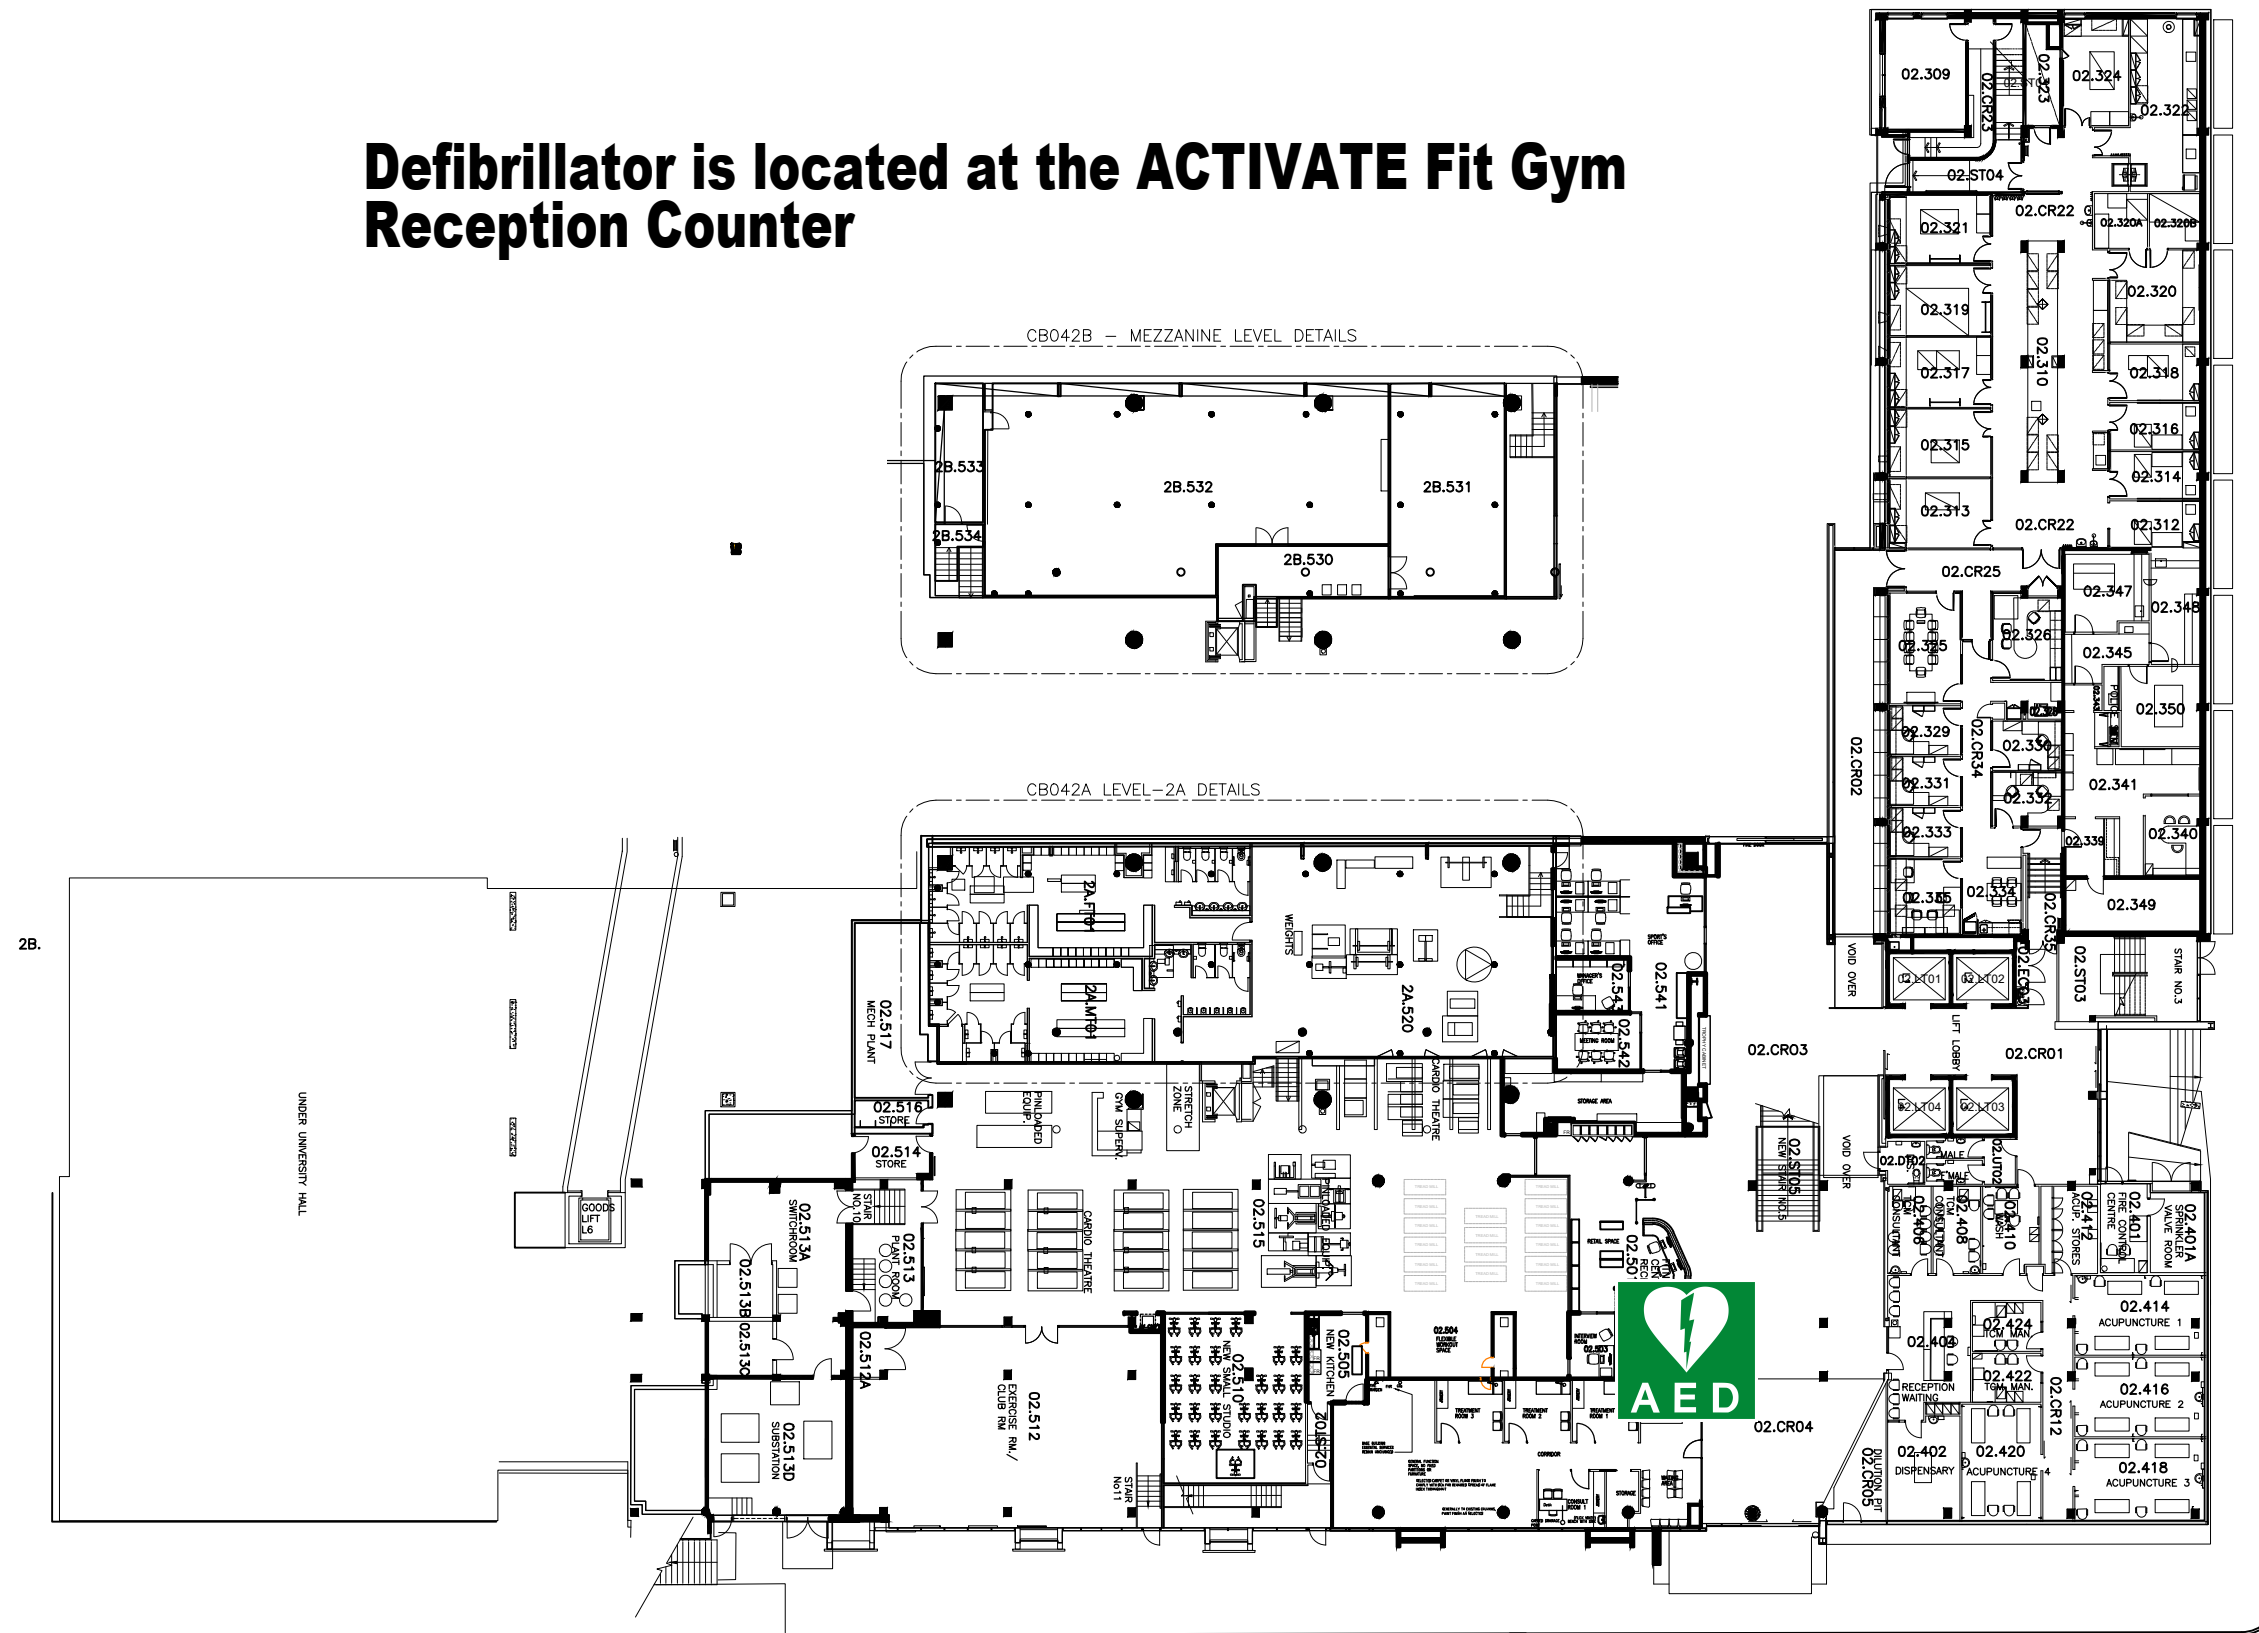



Defibrillator is located at the ACTIVATE Fit Gym Reception Counter

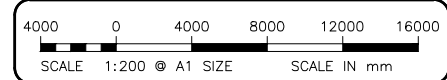

**CITY BROADWAY
BUILDING 4
LEVEL 02**

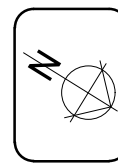

Rev 1 ROOM 1.30 UPGRADE, AUGUST 2012.
WALKTHROUGH CHECKUP, UP TO DATE, JUNE 2011.
UPDATED TO AS BUILT, OCT. 2006

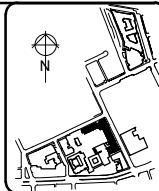

Facilities Management Operations

AS BUILT AUGUST 2012

CB0402AP-05217_01

ANTIMENT IN
 PROGRESS