




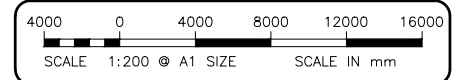

BOTANY PRECINCT BOTANY, BUILDING 01 LEVEL 00

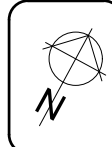

Rev 0 ASBUILT, NOVEMBER 2017
UPDATED AUG 2018

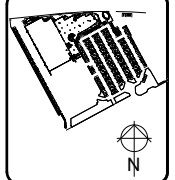

Facilities Management Operations

ASBUILT NOVEMBER 2017

BP0100AP-48341_00

DRAWING IN PROGRESS